

1. Wall and Ceiling Heights

The drawings appear to be plan views only. Please confirm the wall heights and ceiling heights. Ceiling height is 9'0". Wall height will go up to 2nd floor decking 13' 0"

2. Demolition vs. New vs. Existing Conditions


The scope mentions demolition; however, the drawings do not clearly indicate which walls are to be demolished, which are new, and which are to remain existing. Please provide clarification or a revised drawing identifying these conditions. Attached files. Red X are demo. Green highlighted are new.

3. Wall Layout and Ceiling Areas (ACT)

Additional detail is needed to complete a full quantity takeoff for walls and ceiling areas. If available, please provide an RCP or more detailed layouts. We currently do not have a RCP created.

4. Aluminum Storefront System

Please confirm if there is a specified manufacturer/system, or if we should proceed with assumptions for pricing. Proceed with assumptions for pricing. No specific manufacturer is required.

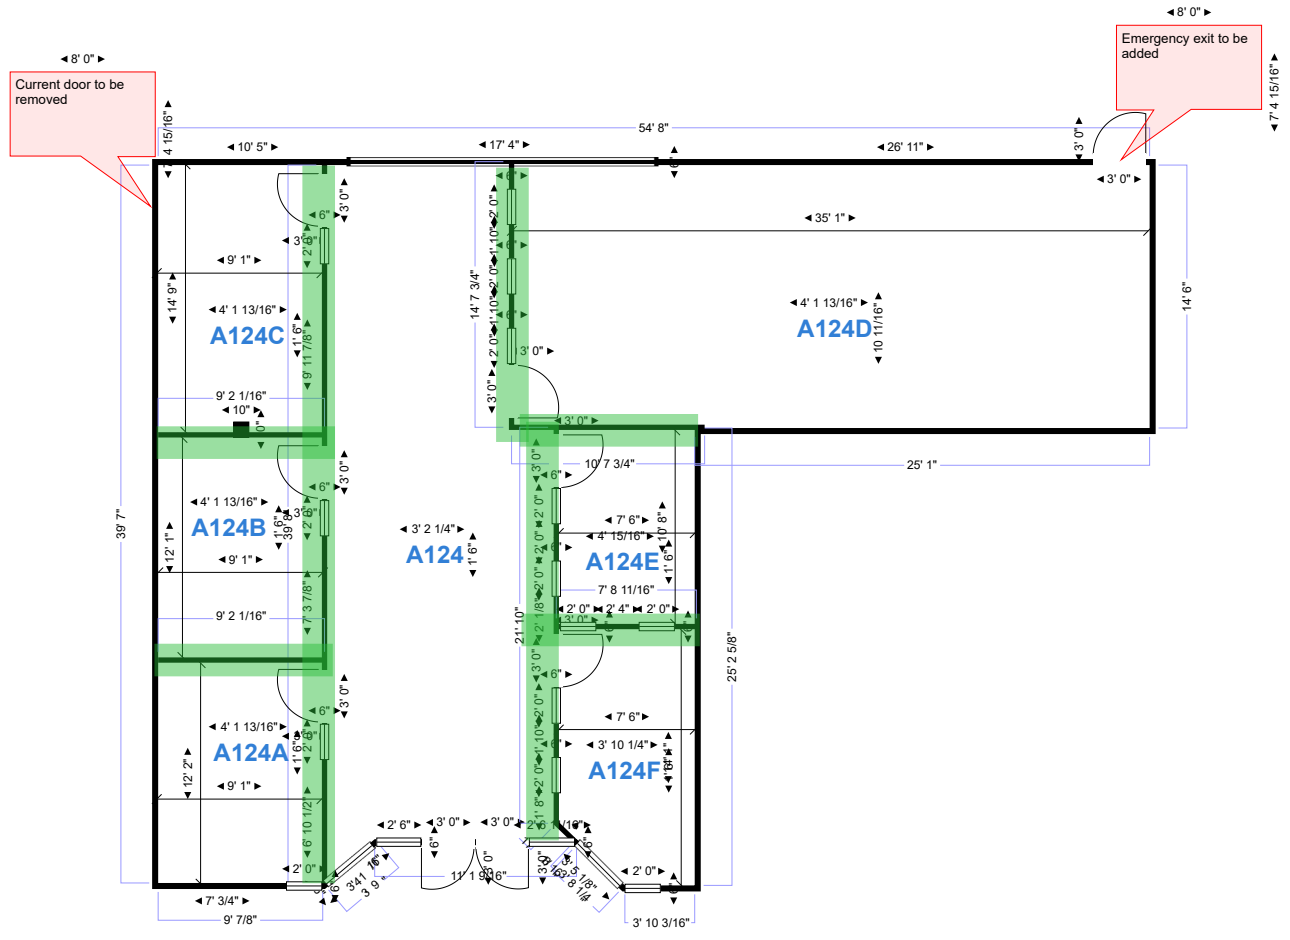

Site: 9910 Administration Sq.	Drawing: 801506	Project: 0000416	Drawn: Name	Notes:	Acme Builders Corp 1234 Oak Road Yorktown, NY 10598
Title: 1st Floor Office Remodel	Scale: 1/4" = 1' 0"	Date: 01/30/2017	Rev: A		